


Pipeline Commodity Classification Movement Map

Quarter 1, 2024

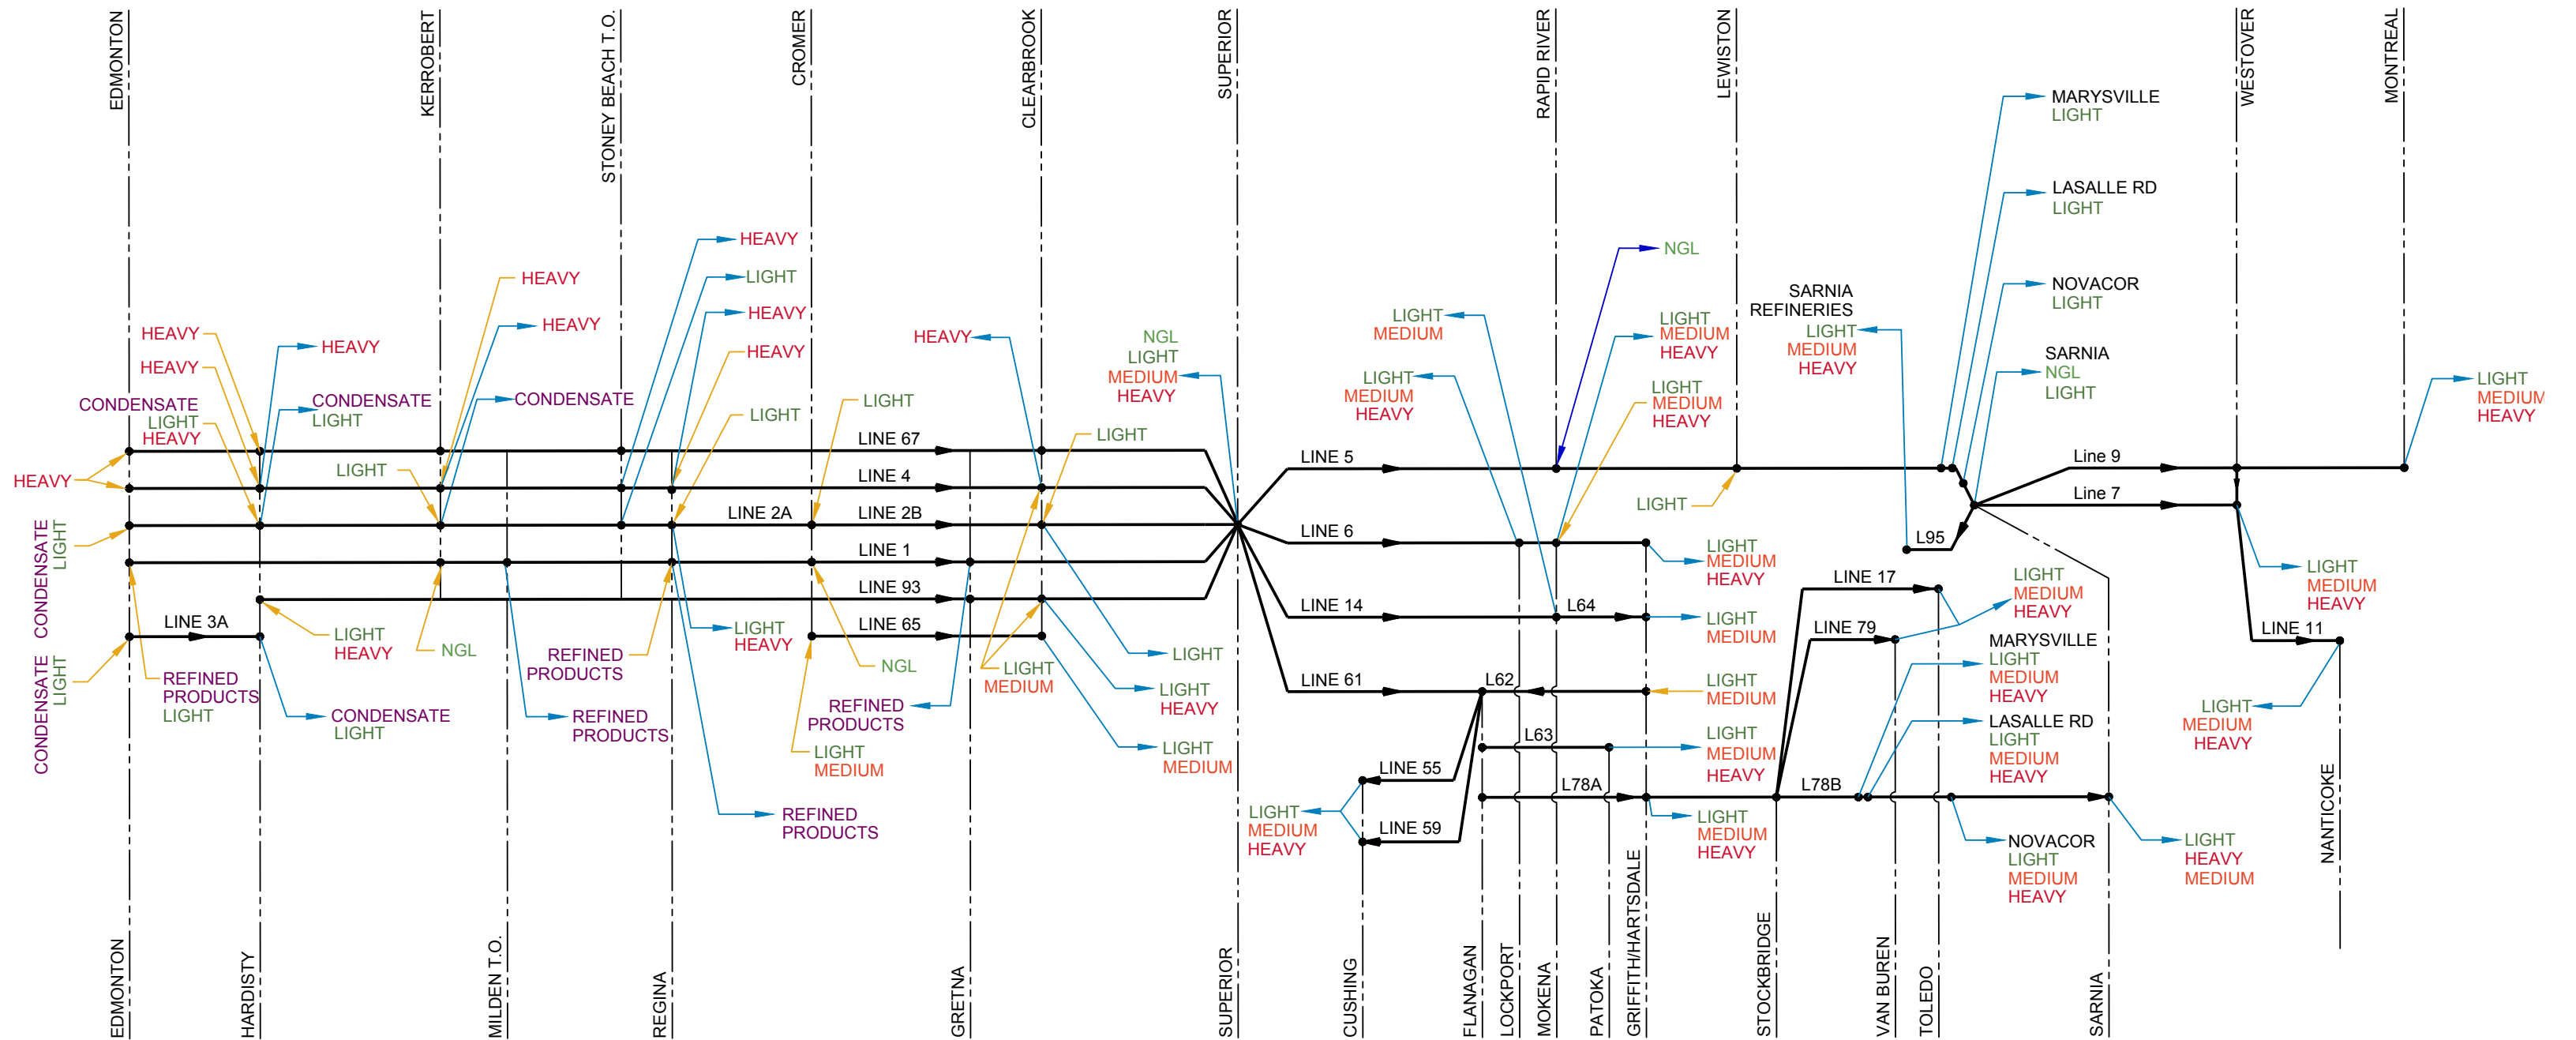

Commodity movement legend

- ← INJECTION
- DELIVERY
- ↔ DELIVERY/INJECTION

REFERENCE DRAWINGS				
NO	REVISION	DESCRIPTION	DATE	BY
3	AS-BUILT IDR 2526	REDLINE MARKUP DATE: 2023-02-01	2023-02-02	ENB
2	AS BUILT AFE 20005598 IDR 1898	REDLINE MARKUP DATE: 2022-01-20	2022-01-20	ENB
1	AS BUILT AFE 20005598 IDR 1898	REDLINE MARKUP DATE: 2021-11-30	2021-11-30	ENB

COPYRIGHT © THIS DRAWING IS THE PROPERTY OF ENBRIDGE AND SHALL NOT BE REPRODUCED EITHER IN WHOLE OR IN PART WITHOUT PRIOR WRITTEN CONSENT OF ENBRIDGE.

SYSTEM WIDE CA (AB) OVERALL COMMODITY CLASSIFICATION MOVEMENT MAP

BY: MS	CHK: ENB	ENG: ENB	ENB APPR: ENB
DATE: 2021-11-30	SCALE: NTS	STATUS: AS BUILDING	
DWG NO: D-0-0.0-100358-0	REV NO: 3.A		